



City of Cambridge

IN CITY COUNCIL
April 23, 1979

ORDERED:

That, in accordance with the provisions of an ordinance relative to placing and maintaining signs, the Commissioner of Public Works be and hereby is authorized to grant a permit to Broadway After Dark for the erection of a sign at 279 Broadway, Cambridge.


Provided that, before erecting the above named sign, the petitioner shall obtain a permit from the Building Department and file with the City Clerk a satisfactory bond in the sum of Two Thousand Dollars (\$2,000) conditioned to save harmless the City of Cambridge from all claims for damages arising from the construction, maintenance and use of said sign.

In City Council April 23, 1979
Adopted by the affirmative vote of 8 members.
Attest: Paul E. Healy, City Clerk

A true copy,


ATTEST:

A handwritten signature in black ink, reading "Paul E. Healy". The signature is written in a cursive style with a large, looping initial "P".

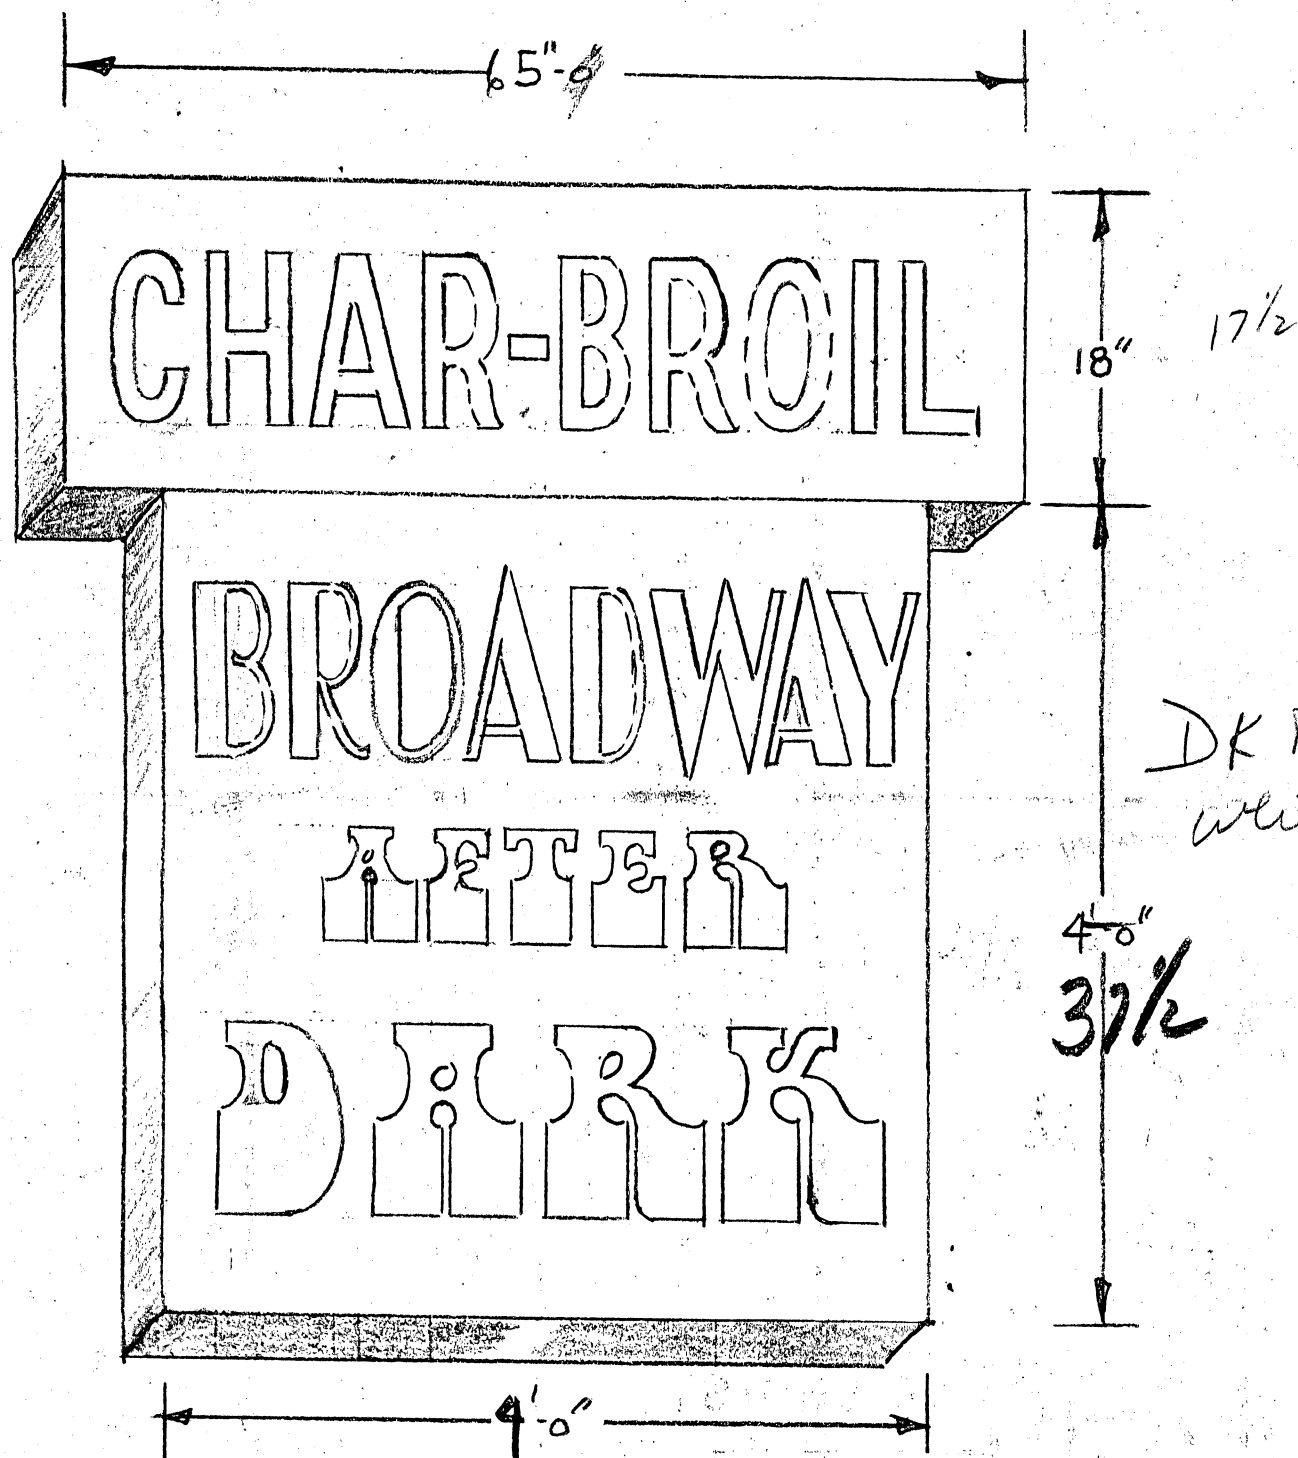

SIGNS BY DESIGN INC

SCALE 1" = 1'-0"

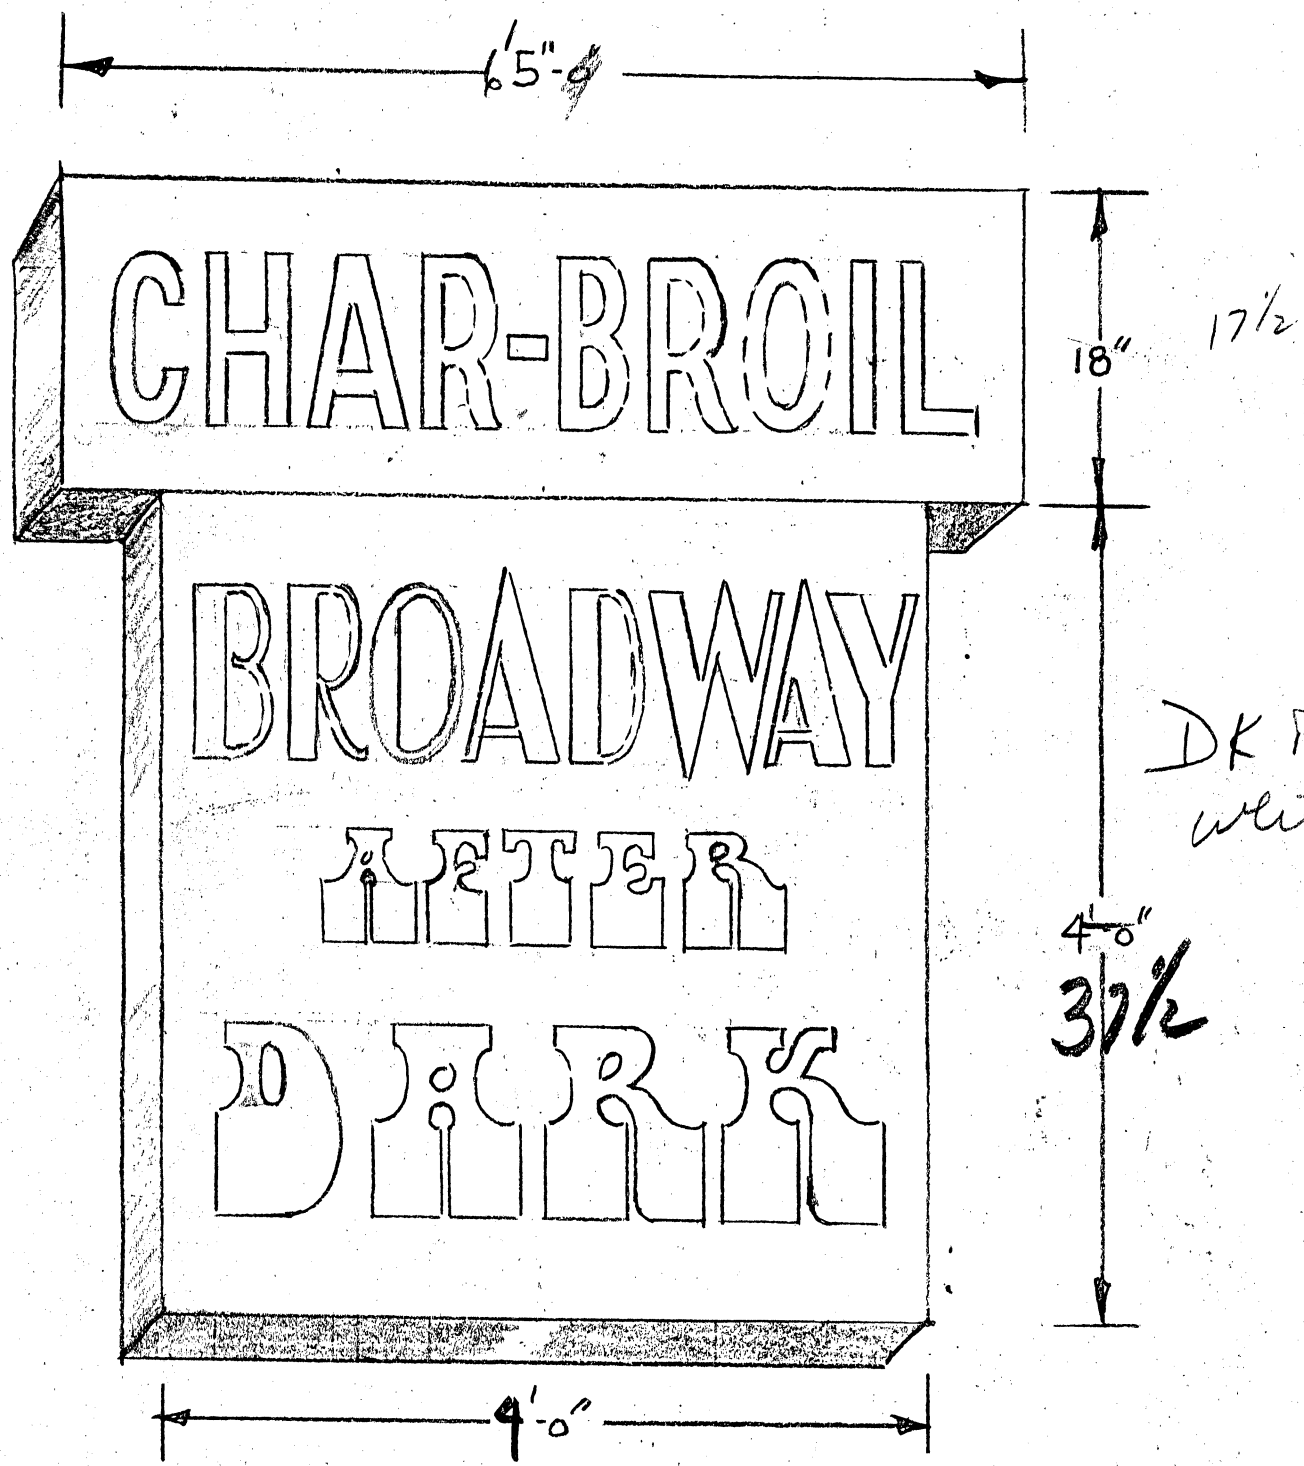

SIGNS BY DESIGN INC
SCALE 1" = 1'-0"



City of Cambridge

MASSACHUSETTS

BUILDING DEPARTMENT

Charles F. Sprague
Supt. of Buildings and
Inspector of Buildings

To Whom It May Concern:

As ~~owner~~ or agent of ARCO GAS STATION 277 BROADWAY
Cambridge, Massachusetts, I do hereby declare my ~~disapproval~~
approval X of the installment of,
Canopy over the sidewalk entrance: _____

Awnings over the windows: _____

Projecting sign: 5'6" x 5'6"

of said property.

Signed: Al Martin Date: 11/23/79

Address: 277 Broadway

Reply is requested within seven (7) days of the date of this letter.



City of Cambridge

MASSACHUSETTS

BUILDING DEPARTMENT

Charles F. Sprague
Supt. of Buildings and
Inspector of Buildings

To Whom It May Concern:

As ~~owner~~ or agent of 281 BROADWAY

Cambridge, Massachusetts, I do hereby declare my ~~disapproval~~

approval X of the installment of,

Canopy over the sidewalk entrance: _____

Awnings over the windows: _____

Projecting sign: 5'6" x 5'6"

of said property.

Signed: Anthony Antonucci

Date: APRIL 23 1979

Address: 281 Broadway

Reply is requested within seven (7) days of the date of this letter.

Cambridge, APRIL 23 1979

To the Honorable, the City Council of the City of Cambridge:

PRIOR TO APPROVAL OF THE CITY COUNCIL, EACH PETITION MUST BE ACCOMPANIED BY A DRAWING OF PROPOSED SIGN, INDICATING DESIGN AND DIMENSIONS AND LOCATION ON PREMISES.

The undersigned respectfully prays that BROADWAY AFTER DARK be granted permit to erect a sign of the following specifications in front of premises 279 BROADWAY

Type: ELECTRIC - ALUMINUM & PLEXI GLASS
(State whether Electric or otherwise and material used in construction)

Reading matter to go on sign: CHAR - BROIL
BROADWAY AFTER DARK

Size: 5'6" X 5'6"

Weight: 100, LBS

How Erected: A: 6' B: 10'
(A: Give exact distance sign is to extend from building over sidewalk.)
(B: Also exact distance from bottom of sign to sidewalk.)

Height Above Grade: Bottom 10' Top 15'6"

SIGNS BY DESIGN, Charles Levine
(Signature of Applicant)

3607 WASHINGTON ST. JAMICA PLAIN MASS.
(Address)

NOTICE - REGULATIONS

SECTION 1412.0 STATE BUILDING CODE

PROJECTING SIGNS

1. A projecting sign shall be constructed wholly of incombustible materials.
2. All signs must meet requirements of Zoning Ordinances and Building Code.

APPROVED: J. Flanagan
Building Inspector

4.23.79
Date

PETITION

of Broadway After Dark
for sign
No. 279 Broadway

April 23 19 79

4/23/79

Order Admored

CS/A

In City Council, April 23 19 79

Referred to the Committee on

Attest:

City Clerk