



City of Cambridge

Calendar Item No. 14

IN CITY COUNCIL

March 21, 1983

ORDERED:

That, in accordance with the provisions of an ordinance relative to placing and maintaining signs, the Commissioner of Public Works, be and hereby is authorized to grant a permit to The Program Store for the erection of a sign at 13 Dunster Street.

Provided that, before erecting the above named sign, the petitioner shall obtain a permit from the Building Department and file with the City Clerk a satisfactory bond in the sum of Two Thousand Dollars (\$2,000.00) conditioned to save harmless the City of Cambridge from all claims for damages arising from the construction, maintenance and use of said sign.

In City Council March 21, 1983.

Adopted by the affirmative vote of 9 members.

Attest:- Paul E. Healy, City Clerk.

A true copy;

ATTEST:-

A handwritten signature in cursive script, reading "Paul E. Healy".



City of Cambridge

Calendar Item No. 14

IN CITY COUNCIL

March 21, 1983

ORDERED:

That, in accordance with the provisions of an ordinance relative to placing and maintaining signs, the Commissioner of Public Works be and hereby is authorized to grant a permit to The Program Store for the erection of a sign at 13 Dunster Street.

Provided that, before erecting the above named sign, the petitioner shall obtain a permit from the Building Department and file with the City Clerk a satisfactory bond in the sum of Two Thousand Dollars (\$2,000.00) conditioned to save harmless the City of Cambridge from all claims for damages arising from the construction, maintenance and use of said sign.

In City Council March 21, 1983.


Adopted by the affirmative vote of 9 members.

Attest:- Paul E. Healy, City Clerk.

A true copy;

ATTEST:-

A handwritten signature in cursive script, reading "Paul E. Healy".

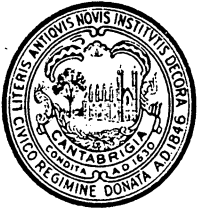

CITY OF CAMBRIDGE

CITY HALL, CAMBRIDGE, MASSACHUSETTS 02139 • (617) 876-6800

BUILDING DEPARTMENT

CHARLES F. SFRAGUE
SUPT. OF BUILDINGS AND
INSPECTOR OF BUILDINGS

To Whom It May Concern:

As an abutter of 13 DUNSTER ST

Cambridge, Massachusetts, I do hereby declare my disapproval_____

approval X of the installment of,

Canopy over the sidewalk entrance:_____

Awnings over the windows:_____

Projecting sign: 3'x3' The PROGRAM STORE

of said property.

Signed: Sandra E. Lagreca Date: 2-23-83

Address 11 Dunster St., Cambridge

Reply is requested within seven (7) days of the date of this letter.



CITY OF CAMBRIDGE

CITY HALL, CAMBRIDGE, MASSACHUSETTS 02139 • (617) 876-6800

BUILDING DEPARTMENT


CHARLES F. SFRAGUE
SUPT. OF BUILDINGS AND
INSPECTOR OF BUILDINGS

To Whom It May Concern:

As an abutter of 13 DUNSTER ST.
Cambridge, Massachusetts, I do hereby declare my disapproval _____
approval X of the installment of,
Canopy over the sidewalk entrance: _____
Awnings over the windows: _____
Projecting sign: 3' x 3' ~~4' x 4'~~ THE PROGRAM STORE
of said property.

Signed: Jessica M. Leahy Date: FEB 23 1983
Address: 15 Dunster St

Reply is requested within seven (7) days of the date of this letter.

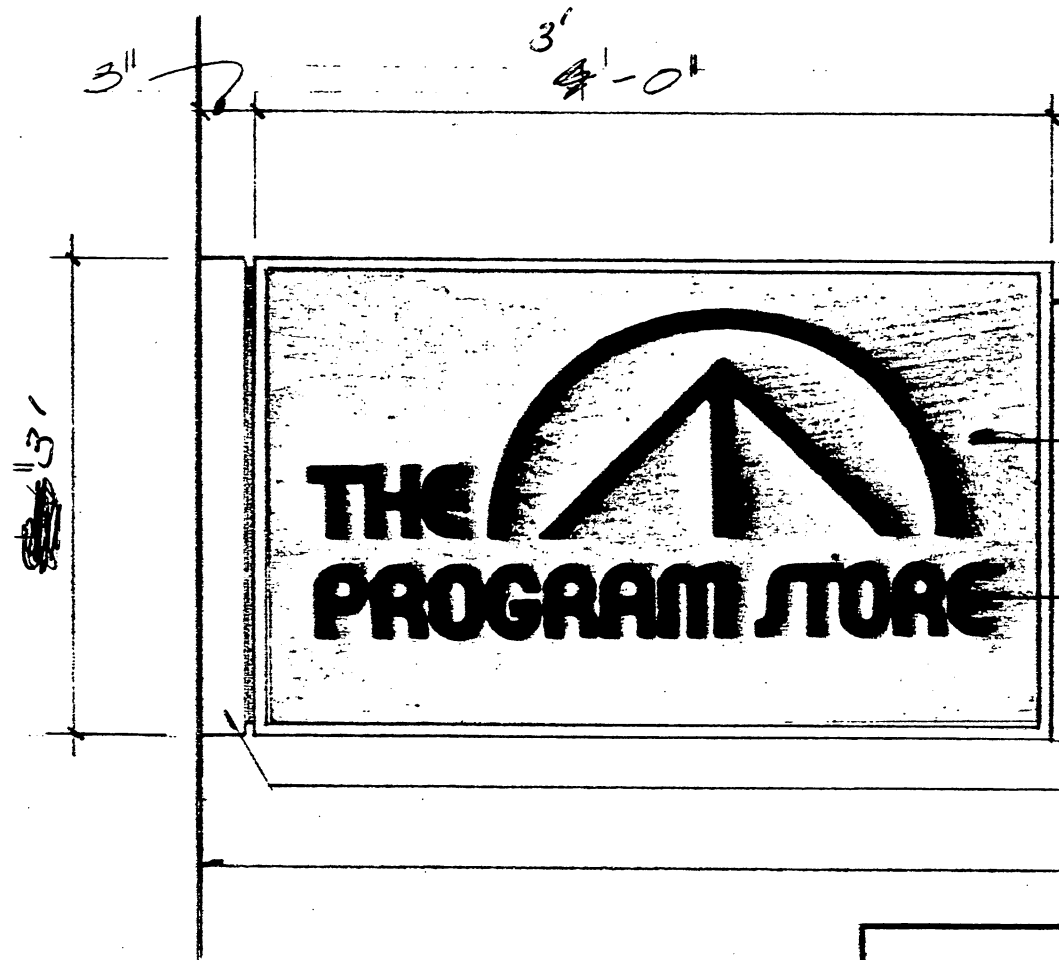

EXTRUDED ALUM. CABINET, PNT'D.
METAFLUX 313 DURANODIC

.063 ALUM. FACE, PNT'D.
METAFLUX MK-2-383 GOLD

COPY + LOGO PNT'D. 313 DURANODIC

EXTRUDED ALUM. MOUNTING
BRACKET, PNT'D. 313 DURANODIC
EXTERIOR WALL

DOUBLE FACE
NON-ILLUMINATED
PROJECTING SIGN MOUNTED
ON EXTERIOR WALL

GENERAL SIGN & LIGHT. INC.
24 BORDER STREET
WEST NEWTON, MA. 02165

SCALE: 1" = 1'-0"

APPROVED BY


DRAWN BY

DATE: 2.15.83

13 DUNSTER ST., CAMBRIDGE, MA.

THE PROGRAM STORE

DRAWING NUMBER
835120

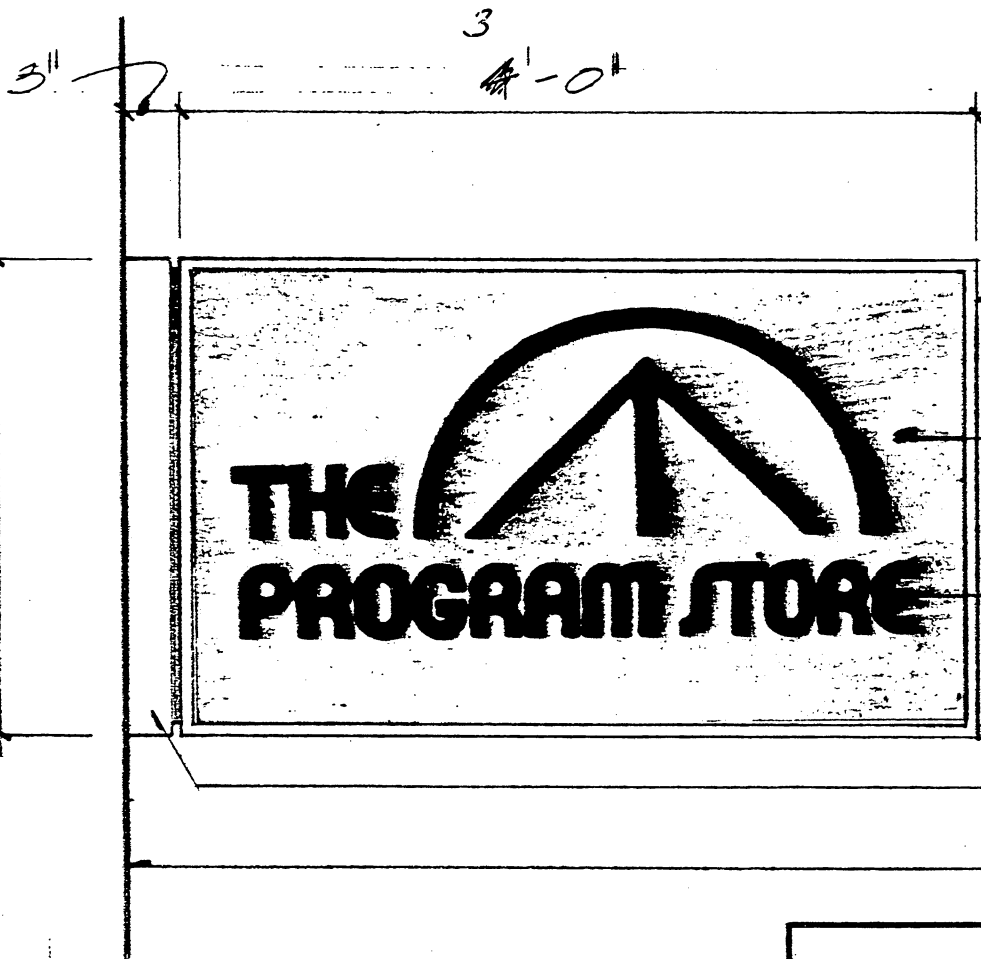

EXTRUDED ALUM. CABINET, FNT'D,
METAFLEX 313 DURANODIC

.063 ALUM. FACE, FNT'D,
METAFLEX MK-2-383 GOLD

COPY + LOGO FNT'D, 313 DURANODIC

EXTRUDED ALUM. MOUNTING
BRACKET, FNT'D, 313 DURANODIC
EXTERIOR WALL

DOUBLE FACE

NON-ILLUMINATED
PROJECTING SIGN MOUNTED
ON EXTERIOR WALL

GENERAL SIGN & LIGHT, INC.
24 BORDER STREET
WEST NEWTON, MA. 02165

SCALE: 1" = 1'-0"

APPROVED BY

DRAWN BY

DATE: 2.5.83

13 DUNSTER ST., CAMBRIDGE, MA.

THE PROGRAM STORE

DRAWING NUMBER
835120

Cambridge, Feb 23 1983

To the Honorable, the City Council of the City of Cambridge:

PRIOR TO APPROVAL OF THE CITY COUNCIL, EACH PETITION MUST BE ACCOMPANIED BY A DRAWING OF PROPOSED SIGN, INDICATING DESIGN AND DIMENSIONS AND LOCATION ON PREMISES.

The undersigned respectfully prays that THE PROGRAM STORE be granted permit to erect a sign of the following specifications in front of premises 13 DUNSTER ST.

Type: ALUMINUM
(State whether Electric or otherwise and material used in construction)

Reading matter to go on sign: THE PROGRAM STORE & LOGO

Size: ~~4' X 26"~~ 3' X 3'

Weight: 50-135 ²⁵⁰⁰⁰

How Erected: A: 3' 3" B: 10'
(A: Give exact distance sign is to extend from building over sidewalk.)
(B: Also exact distance from bottom of sign to sidewalk.)

Height Above Grade: Bottom 10' Top 12' 6"

GENERAL SIGN & LIGHT INC. Charles Levine
(Signature of Applicant)

24 BORDER ST. WEST NEWTON MASS 02165
(Address)

NOTICE - REGULATIONS

SECTION 1412.0 STATE BUILDING CODE

PROJECTING SIGNS

1. A projecting sign shall be constructed wholly of incombustible materials.
2. All signs must meet requirements of Zoning Ordinances and Building Code.

APPROVED:  2/23/85
Building Inspector Date

332-2000

6. #14H-25

PETITION

of The Program Store

for a sign

No. 13 Dunster Street

February 23, 19 83

*2/28/1983
Filed by E. Rockney*

In City Council, February 28 19 83

Referred to the Committee on

Attest:

2/21/83

City Clerk

*17K
A*

Order

Advised

on

Motion of

E. Rockney

*CHJS
JF
RF/A*

RECEIVED BY
OFFICE OF CITY CLERK

FEB 23 11 32 AM '83

CAMBRIDGE, MASS.