

put in the paper

TO

Mr Kealy

DATE

6/15

TIME

9:00

WHILE YOU WERE OUT

Clinton Cleary

PHONE

TELEPHONED	PLEASE CALL	☒
CALLED TO SEE YOU	WILL CALL AGAIN	☐

MESSAGE

876-5099

Ref. petition before
the Council last night

MESSAGE RECEIVED BY W



City of Cambridge

Communication No. 6

IN CITY COUNCIL

June 21, 1982

ORDERED:

That, in accordance with the provisions of an ordinance relative to placing and maintaining signs, the Commissioner of Public Works be and hereby is authorized to grant a permit to W. Clinton Creasy ^{an awning} for the erection of ~~XXXXX~~ at 142A Mount Auburn Street. ^{awning}

Provided that, before erecting the above named ~~XXXX~~ ^{awning}, the petitioner shall obtain a permit from the Building Department and file with the City Clerk a satisfactory bond in the sum of Two Thousand Dollars (\$2,000.00) conditioned to save harmless the City of Cambridge from all claims ^{for} ~~XXXXX~~ ^{awning.} damages arising from the construction, maintenance and use of said ~~XXXXX~~


In City Council June 21, 1982.

Adopted by the affirmative vote of 6 members.

Attest:- Paul E. Healy, City Clerk.

A true copy;

ATTEST:-

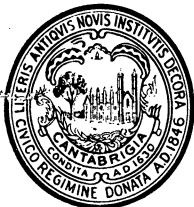

CITY OF CAMBRIDGE

RECEIVED BY
OFFICE OF CITY CLERK
CITY HALL, CAMBRIDGE, MASSACHUSETTS 02139 • (617) 498-9013

JUN 10 9 42 AM '82

BUILDING DEPARTMENT

CAMBRIDGE, MASS.

JOSEPH J. CELLUCCI
SUPT. OF BUILDINGS AND
INSPECTOR OF BUILDINGS

To Whom It May Concern:

As owner or agent of 144 Mt. Auburn St. (abutter to 142A),
Cambridge, Massachusetts, I do hereby declare my disapproval _____
approval ✓ of the installment of:

Canopy over the sidewalk entrance: 1


Awnings over the windows: 2

Projecting sign: _____

of said property.

Signed: Paul Pizzi Date: 9 June '82
Address: 144R Mt. Auburn St. Cambridge, Ma 02138

Reply is requested within seven (7) days of date of this letter.

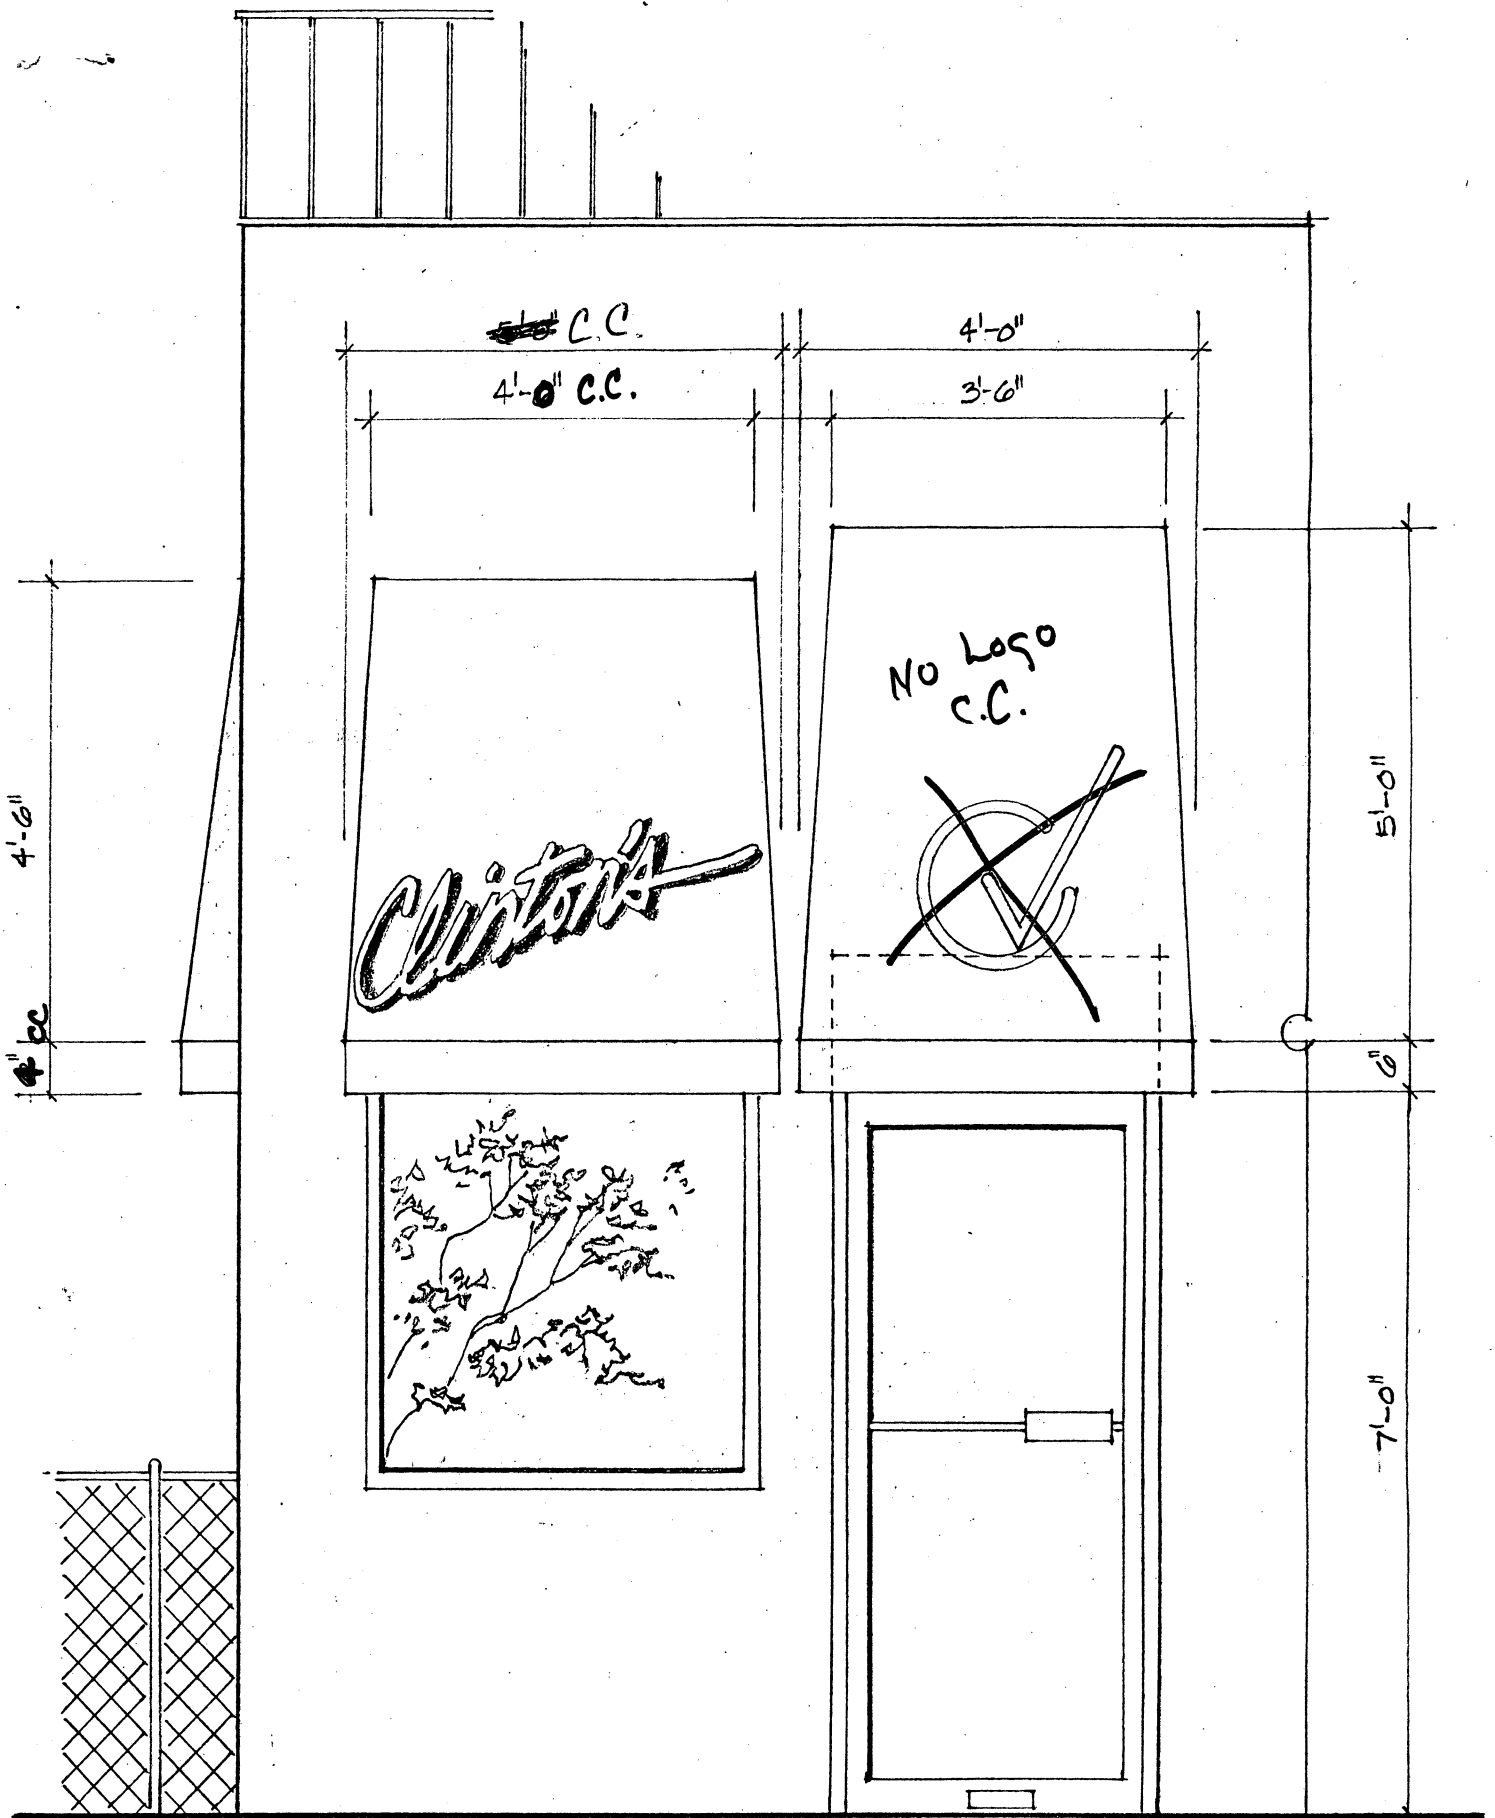


CLINTON'S

142A MT. ALDRICH
CAMBRIDGE, MA.

AWNING ADDITION

NORTH ELEVATION
1/2" = 1'-0"

27 MAY '82

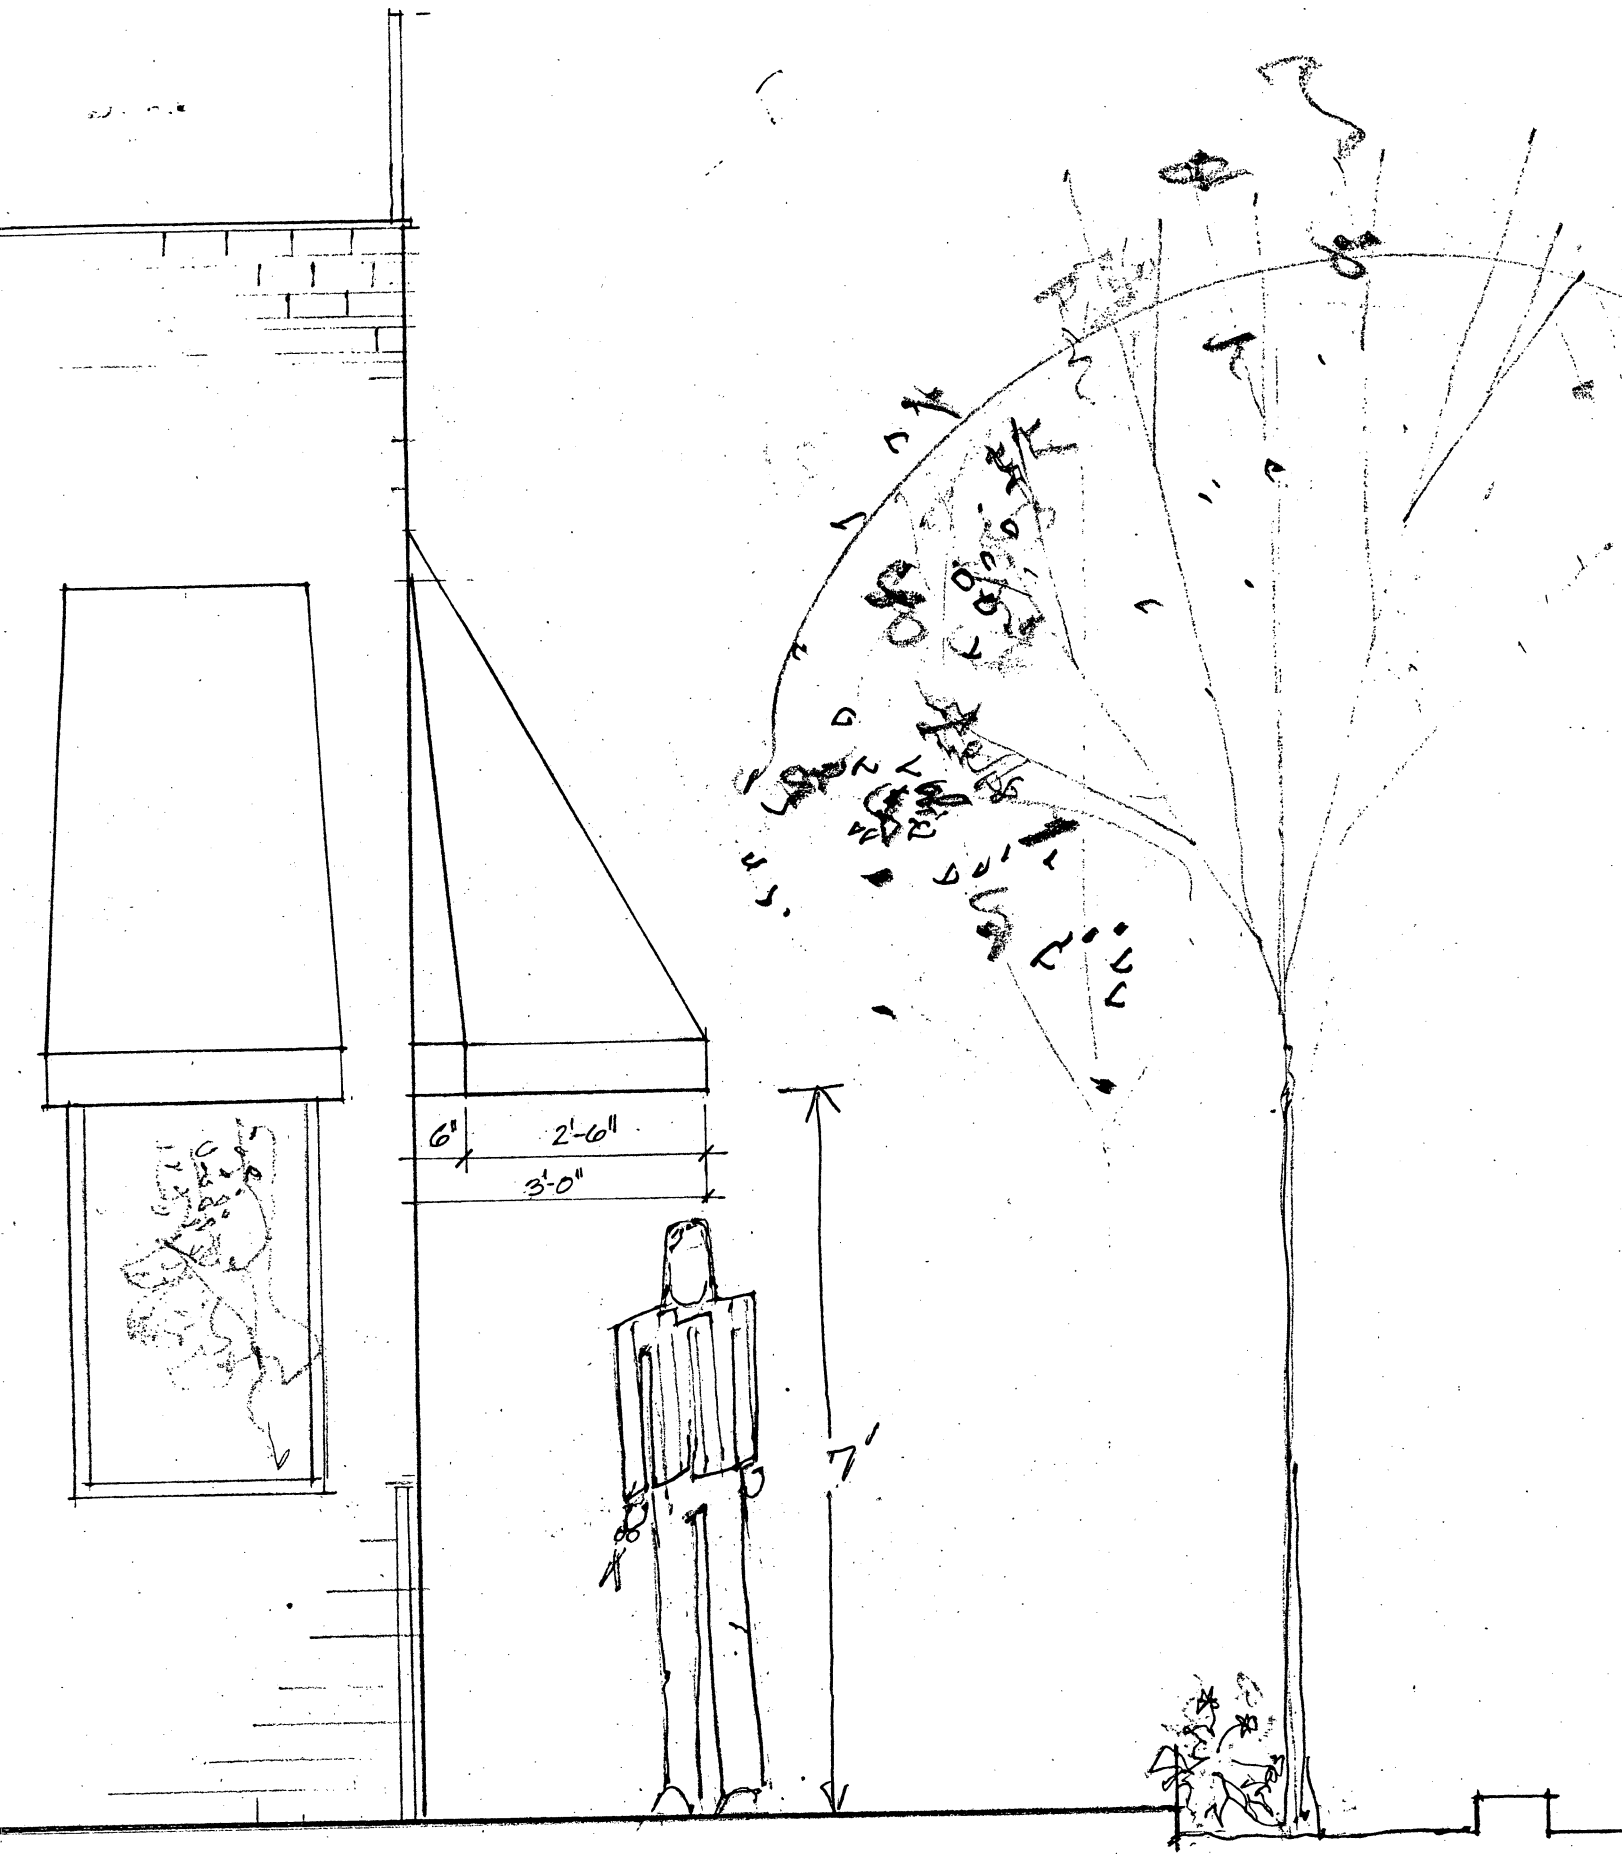

CLINTON'S

AWNING ADDITION

EAST ELEVATION

1/2" = 1'-0"

27 MAY '02

Cambridge, 28 May 1982

To the Honorable, the City Council of the City of Cambridge:

PRIOR TO APPROVAL OF THE CITY COUNCIL, EACH PETITION MUST BE ACCOMPANIED BY A DRAWING OF PROPOSED SIGN, INDICATING DESIGN AND DIMENSIONS AND LOCATION ON PREMISES.

The undersigned respectfully prays that Clinton CREASY be granted permit to erect ^{an awning} ~~a sign~~ of the following specifications in front of premises at 142A Mt. Auburn St.

Type: Stationary Canvas
(State whether Electric or otherwise and material used in construction)

Reading matter to go on sign: ~~CL Logo~~ Clinton's

Size: SEE drawing

Weight: 50

How Erected: A: 3' (over door) B: 6' (over window) B: 7'
(A: Give exact distance sign is to extend from building over sidewalk.)
(B: Also exact distance from bottom of sign to sidewalk.)

Height Above Grade: Bottom 7' Top 12'

W. Clinton Creasy
(Signature of Applicant)

142A Mt. Auburn St - Camb 02138
(Address)

367-3298

NOTICE - REGULATIONS

SECTION 1412.0 STATE BUILDING CODE

PROJECTING SIGNS

1. A projecting sign shall be constructed wholly of incombustible materials.
2. All signs must meet requirements of Zoning Ordinances and Building Code.

APPROVED: G. Libeste
Building Inspector

6-2-82
Date

PETITION

of W. Clinton Creasy
for an awning
No. 142 A Mt. Auburn Street

June 14 1982

Note 6/14/82
Draw up order
for 6/21/82
NO ACTION 6/24/82

In City Council, ~~June 14, 1982~~
June 21, 1982
Referred to the Committee on

Attest:

City Clerk

6/21/82

CC Order Adopted