

LEGEND

- METAL STUD WALL
- MTL. STUD WALL W/ CERAMIC TILE
- WALK-IN BOX WALL
- MASONRY WALL
- WALL ABOVE / SOFFIT
- COLUMN LINE
- COLUMN / WIDE FLANGE
- SECTION/DETAIL
- ELEVATION INDICATOR

NOTES

KEY PLAN

SCALE: 1/4" = 1'-0"



au bon pain.

THE FRENCH BAKERY CAFE

AU BON PAIN CO., INC.
19 FID KENNEDY AVENUE
BOSTON, MA. 02210-2497
(617) 423-2100

PROJECT LOCATION:

HARVARD SQUARE
27 BRATTLE ST.
CAMBRIDGE, MA
02138

ARCHITECT:

AU BON PAIN CO., INC.
19 FID KENNEDY AVENUE
BOSTON, MA. 02210-2497
(617) 423-2100

ENGINEER:

Drawn by: JUG Checked by: Date: 7/24/92

No. Date: Revision:

APPROVALS:

OPERATIONS: Date:

LB
JB

DEVELOPMENT: Date:

PM
DC

LANDLORD: Date:

PRESIDENTIAL APPROVAL: Date:

SHEET TITLE:

FLOOR PLAN
existing conditions


SHEET NO. OF

SHEET NO. AB-1

HARVARD SQUARE

1 BASEMENT FLOOR PLAN

AB-1 1/4" = 1'-0"

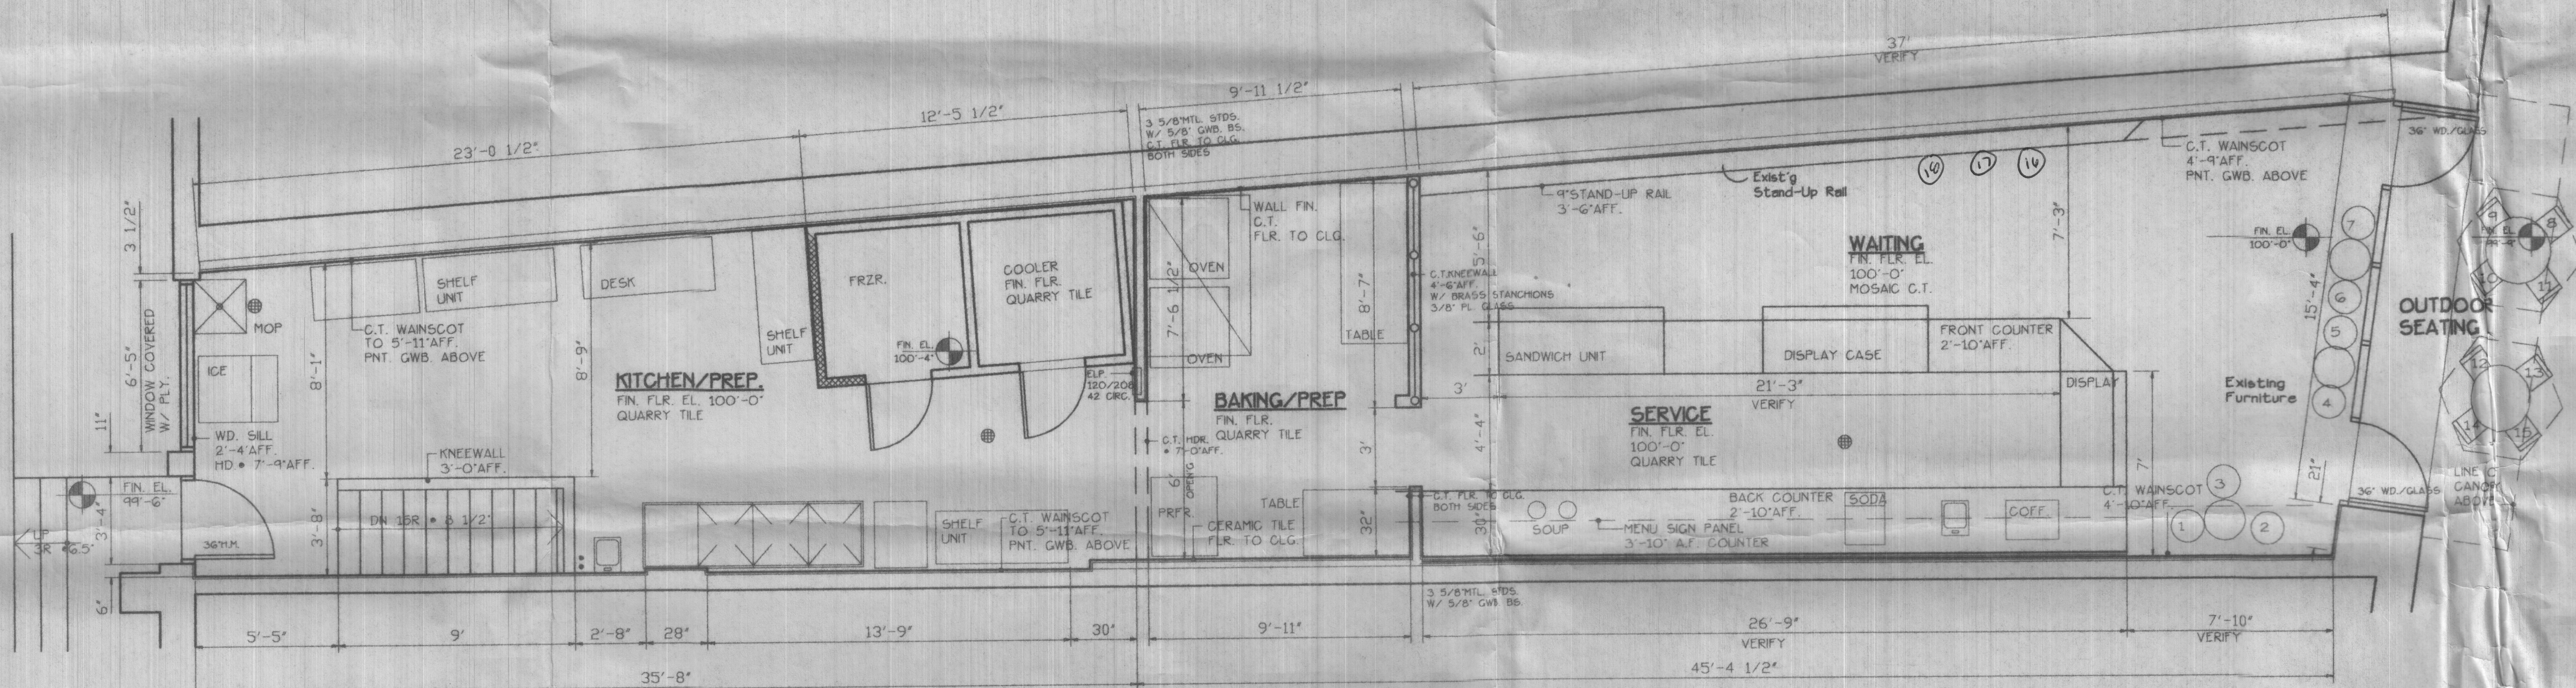

2 GROUND FLOOR PLAN

AB-1 1/4" = 1'-0"

OFFICE OF CITY CLERK

1988 FEB 17 PM 3:40

CAMBRIDGE MA.

RECEIVED BY
OFFICE OF CITY CLERK

1993 FEB 17 PM 3:40

Cambridge, February 17 19 93

To the Honorable, the City Council of the
City of Cambridge

Au Bon Pain Co., D/B/A/
Warburtons

The undersigned respectfully pray

_____, LOCATED AT 27 Brattle Street
NAME OF PETITIONER OR BUSINESS ADDRESS OF PETITIONER OR BUSINESS

BE GRANTED PERMISSION FOR A/AN () "A" FRAMED SIGN, (X) TABLE* () SANDWICH BOARD OR,
() DISPLAY OF MERCHANDISE.

*Seasonal outdoor seating

IN FRONT OF PREMISES NUMBERED 27 Brattle Street, ON
ADDRESS WHERE SIGN WILL BE

Monday through Sunday, FROM 7 A.M. AM TO 9 P.M. PM.
LIST THE DAYS OF THE WEEK

Au Bon Pain Co., D/B/A Warburtons
by The Georges Company

George J. Georges (BDF)
PETITIONER'S SIGNATURE
George J. Georges

George J. Georges
PRINT NAME HERE

(617) 227-8338
TELEPHONE #

(617) 876-1609
TELEPHONE #
ADDITIONAL

PLEASE PROVIDE A SKETCH OF YOUR SIGN HERE

SEE ATTACHED PLAN

PETITION

of Au Bon Pain, Co., D/B/A Warbutons

for tables & chairs for seasonal outdoor seating

No. 27 Brattle Street

_____19

*Referred to the
City Manager
with power
Copy sent to City mgr
2/23/93 (de)*

In City Council, 2-22- 1993

Referred to the Committee on

Attest:

City Clerk.